



COPY OF PAPERS  
ORIGINALLY FILED


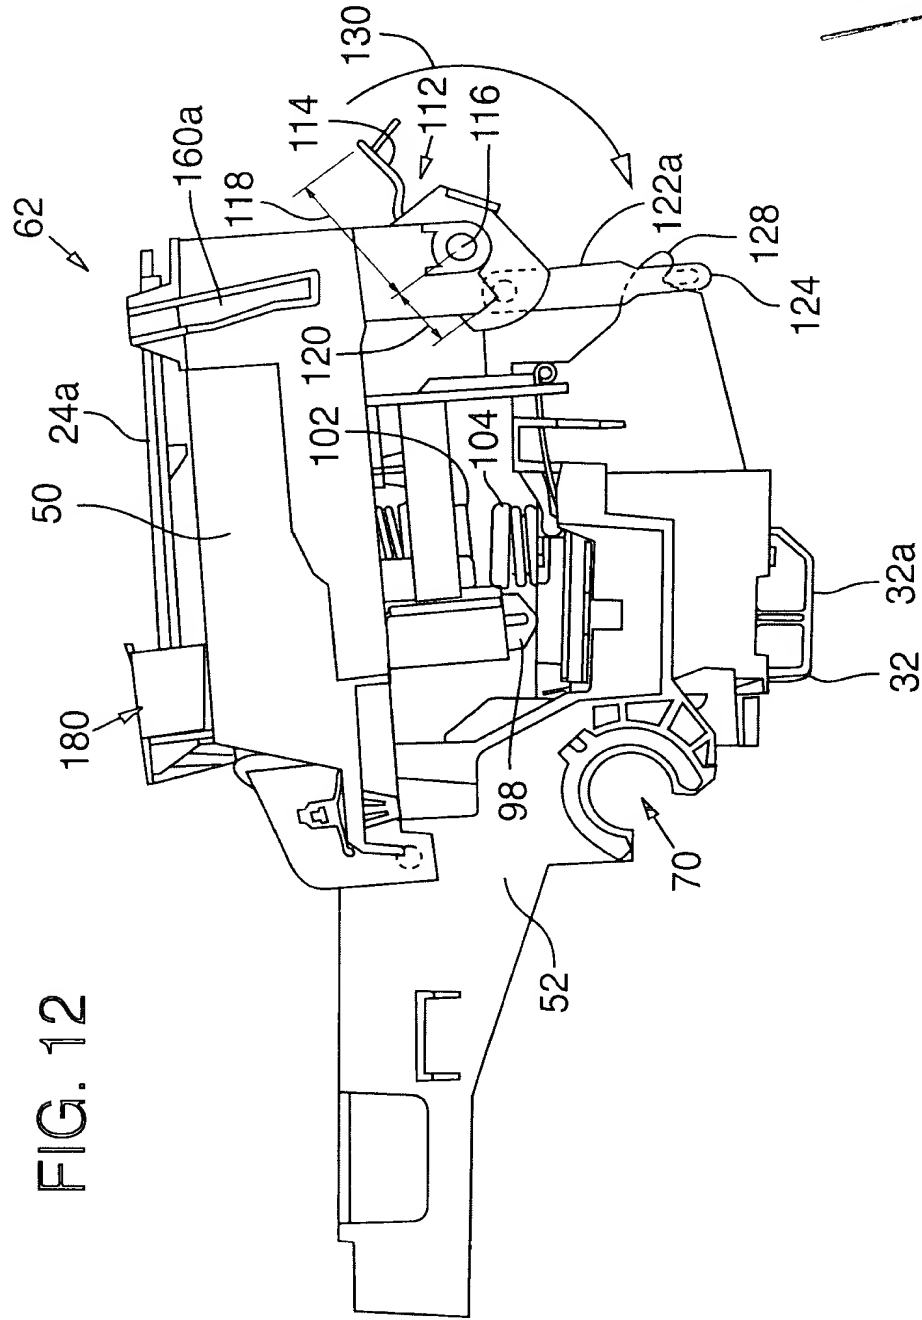


FIG. 12



COPY OF PAPERS  
ORIGINALLY FILED



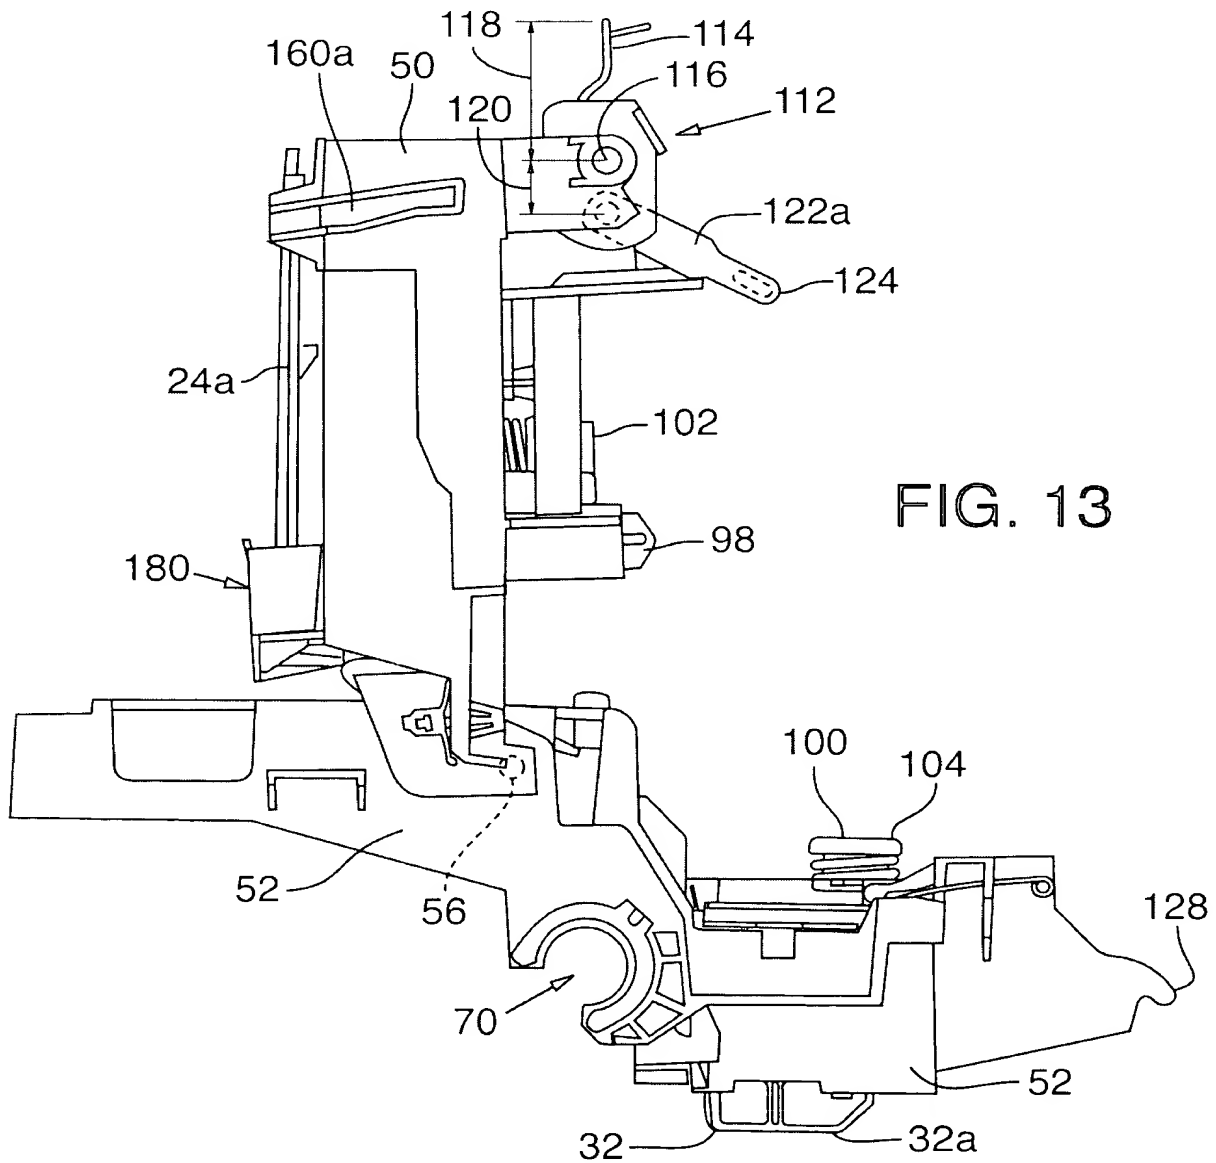

6/7

Redlined Correction of Sheet No. 6.

COPY OF PAPERS  
ORIGINALLY FILED

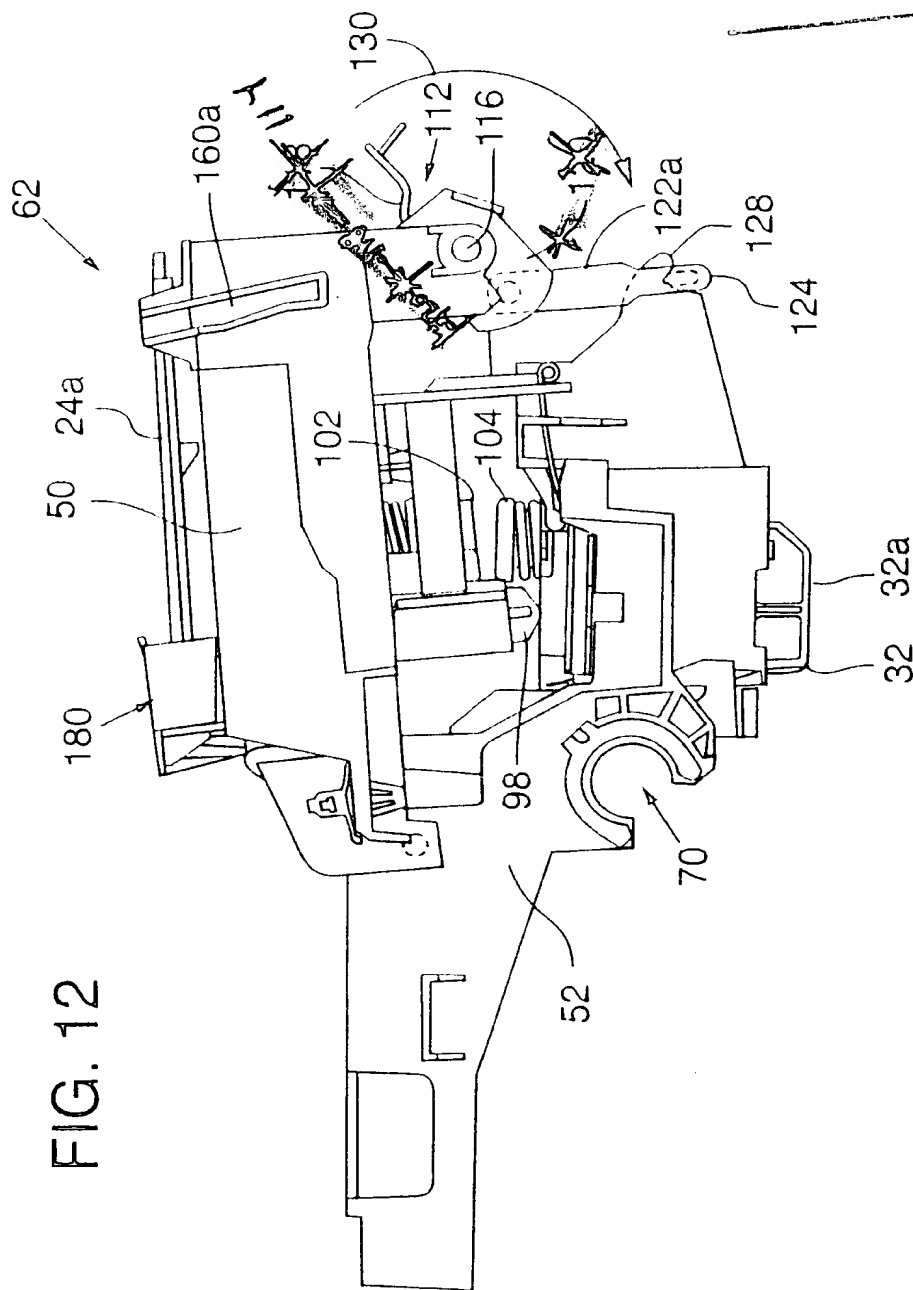


FIG. 12



717

Redlined Correction of Sheet 7.

